Tuesday, 11/6/2007 3:43:00 PM Date Kim Johnston User: Customer : 35593 Job Number : 10464 **Estimate Number** : NIA P.O. Number This Issue Prsht Rev. First Issue : 35287 Previous Run Written By Checked & Approved By Comment **Additional Product** Job Number: Seq. #: 1.0 35593A 35593B D32783 3.0 Comment: Qty.: Pick:

**Process Sheet** : SUPPORT ASSEMBLY **Drawing Name** : CU-DAR001 Dart Helicopters Services : D3278041 Part Number S.O. No. : NA : D3278 REV.C : 11/6/2007 **Drawing Number** : N/A Project Number : C : SMALL /MED FAB **Drawing Revision** Type A/4: Material : 11/30/2007 Each **Due Date** Qty: Um: New issue KJ/JLM 04.04.19 : Est:A **EST** В 07.08.21 Chg rivet per PAR185 EC Verified by: JLM Description: Machine Or Operation: SUPPORT Comment: Sub-Component SUPPORT D3278-1 B 35287A SUPPORT Comment: Sub-Component SUPPORT D3278-2 B 349513 1.0000 Each(s)/Unit Total: 40.0000 Each(s) Spacer Batch 35312 'Qty Part Number Description D3278-3 Spacer 4.0 MS20426AD3 Comment: Qty.: 4.0000 Each(s)/Unit Total: 160.0000 Each(s) **RIVET** Pick: Batch Description **Qty Part Number** MS20426AD3-6 mios Rivet

Page 1

Form: inrocess

### **Dart Aerospace Ltd**

W/O:	W/O: WORK ORDER CHANGES								
DATE	STEP	PROCEDURE CHANGE	Ву	Date	Qty	Approval Chief Eng / Prod Mgr	Approval QC Inspector		
						:			
Part No	<u> </u>	PAR #: Fault Category:	NCR: Yes	No DQ	A:	_ Date: _			
			QA:	N/C Close	d:	_ Date: _			

NCR:		WORK ORDER NON-CONFORMANCE (NCR)							
		Description of NC		Corrective Action Section B			Ammerical		
DATE	STEP	Section A	Initial Chief Eng	Action Description Chief Eng	Sign & Date	Verification Section C	Approval Chief Eng	Approval QC Inspector	
								·	
						•			

NOTE: Date & initial all entries

Tuesday, 11/6/2007 3:43:00 PM Date: Kim Johnston User: **Process Sheet** Drawing Name: SUPPORT ASSEMBLY Customer: CU-DAR001 Dart Helicopters Services Part Number: D3278041 Job Number: 35593 Job Number: Description: Seq. #: **Machine Or Operation:** SMALL & MEDIUM FAB RESOURCE 1 5.0 SMALL FAB 1 Comment: SMALL & MEDIUM FAB RESOURCE 1 Rivet spacers with support as per Dwg D3278. INSPECT WORK TO CURRENT STEP 6.0 QC5 Comment: INSPECT WORK TO CURRENT STEP 7.0 D22301 Mounting Lug 2.0000 Each(s)/Unit Total: 80.0000 Each(s) Comment: Qty.: Mounting Lug Pick: Packing Kit Qty Part Number Description Mounting Lug 2 D2230-1 8.0 AN413A 2.0000 Each(s)/Unit Total: 80.0000 Each(s) Comment: Qtv.: Bolt Pick: Packing Kit Qty Part Number Description 2 AN4-13A Bolt AN960JD416 9.0 Comment: Qty.: 160.0000 Each(s) 4.0000 Each(s)/Unit Total: Washer Pick: Packing Kit Qty Part Number Description Washer 4 AN960JD416 MS21042L4 10.0 Comment: Qty.: 2.0000 Each(s)/Unit Total: 80.0000 Each(s) Nut Pick: Packing Kit Description Qty Part Number MS21042L4 Nut

### Dart Aerospace Ltd

W/O:		WORK ORDER CHANGES							
DATE	STEP	PROCEDURE CHANGE				Date	Qty	Approval Chief Eng / Prod Mgr	Approval QC Inspector
		· .							
/	/								

Part No:	PAR #:	Fault Category:	NCR: Yes No DQA:	Date: <u>Hula</u>
			QA: N/C Closed:	Date:

		WORK OR	DER NON-CONFORMANC	E (NCR)			
	Description of NC		Corrective Action Section B		Varification	Annroyal	Annaval
STEP	Section A	Initial Chief Eng	Action Description Chief Eng			Chief Eng	Approval QC Inspector
:							
			·		,		
	STEP	STEP Description of NC	STEP Description of NC Section A Initial	STEP Description of NC Section A Initial Action Description	STEP Description of NC Section A Initial Action Description Sign &	STEP Section A Initial Action Description Sign & Section C	STEP Description of NC Section A Portion Section B Section A Portion C Section C Secti

NOTE: Date & initial all entries

Tuesday, 11/6/2007 3:43:00 PM Date: Kim Johnston User: **Process Sheet** Drawing Name: SUPPORT ASSEMBLY Customer: CU-DAR001 Dart Helicopters Services Job Number: 35593 Part Number: D3278041 Job Number: Description: Seq. #: Machine Or Operation: SMALL & MEDIUM FAB RESOURCE 1 11.0 SMALL FAB 1 Comment: SMALL & MEDIUM FAB RESOURCE 1 Assemble support as per Dwg D3278. \*\*\*DO NOT TIGHTEN BOLTS\*\*\* Identify as D3278-041 QC5 12.0 Comment: INSPECT WORK TO CURRENT STEP PACKAGING RESOURCE #1 13.0 Comment: PACKAGING RESOURCE #1 Identify and Stock Location: 14.0 QC21 Comment: FINAL INSPECTION/W/O RELEASE Job Completion U. 87-11-21

B35593

935593 932593 93278 041

### **Dart Aerospace Ltd**

W/O:		WORK ORDER CHA	NGES			<del></del>	
DATE	STEP	PROCEDURE CHANGE	Ву	Date	Qty	Approval Chief Eng / Prod Mgr	Approval QC Inspector
Part No	•	PAR #: Fault Category:	NCR: Yes	No DQ	A:	_ Date: _	
			QA: I	N/C Close	d:	Date:	

NCR:		WORK ORDER NON-CONFORMANCE (NCR)								
DATE		Description of NC		Corrective Action Section B		Verification	Approval Chief Eng			
	STEP	Section A	Initial Chief Eng	Action Description  Chief Eng	Sign & Date	Section C		Approval QC Inspector		


NOTE: Date & initial all entries



	DESIG	191	DRAWN BY	DART AEROSPACE LTD HAWKESBURY, ONTARIO, CANADA	
1	CHEC	KED 6	APPROVED,	DRAWING NO.	REV. C
		-A	AH .	D3278 SHEET	1 OF 3
	DATE			TITLE	SCALE
	07.0	7.24		SUPPORT ASSEMBLY	NTS
	Α		04.03.03	NEW ISSUE	
	В		05.03.31	CHANGE DIM/TOL TO ENSURE FIT	
	C		07.07.24	CHANGED RIVETS PER PAR #185	

# DELEASE 107 08.46

## D3278-041 SUPPORT ASSEMBLY

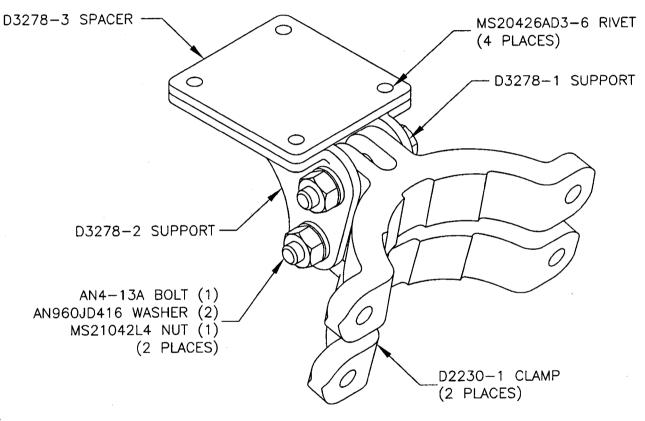


Qty	Part Number	Description	
Х	D3278-041	SUPPORT ASSEMBLY	
	D0000 4	CLAMP	
2	D2230-1 D3278-1	SUPPORT	SHOP COPY
1	D3278-2	SUPPORT	RETURN TO
<del></del> 1	D3278-3	SPACER	
			ENGINEERING COF
2	AN4-13A	BOLT	
4	AN960JD416	WASHER	WITHOU NOTICE
4	MS20426AD3-6	RIVET	WORK ORDER 2
2	MS21042L4	NUT	NO 333


Copyright © 2004 by DART AEROSPACE LTD

THIS DOCUMENT IS PRIVATE AND CONFIDENTIAL AND IS SUPPLIED ON THE EXPRESS CONDITION THAT IT IS NOT TO BE USED FOR ANY PURPOSE OR COPIED OR COMMUNICATED TO ANY OTHER PERSON WITHOUT WRITTEN PERMISSION FROM DART AEROSPACE LTD.



DESIGN	DRAWN BY	DART AEROSP HAWKESBURY, ONTAR	
CHECKED	APPROVED,	DRAWING NO.	REV. C
A	-#	D3278	SHEET 2 OF 3
DATE		TITLE	SCALE
07.07.24		SUPPORT ASSEMBLY	1:1

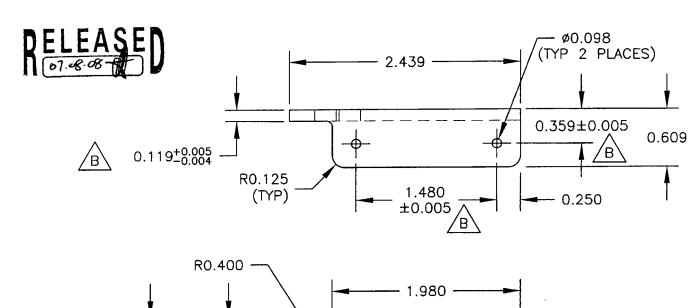

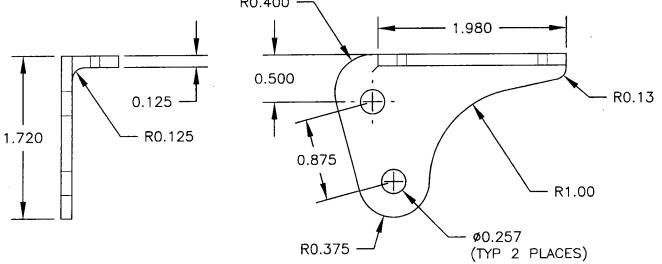

# D3278-1 SUPPORT (SHOWN) D3278-2 SUPPORT (OPPOSITE)

- 1) MACHINE PER DWG FILE "D3278-1.SLDPRT"
- 2) MATERIAL: 6061-T6 (OR 6061-T651/T6510/T6511/T62) BAR

PER AMS-QQ-A-225/8 (OR AMS 4117/4128/4115/4116)

PER AMS-QQ-A-200/8 (OR AMS 4160)

(REF. DART SPEC. M6061T6B)

3) FINISH: CHEMICAL CONVERSION COAT PER DART QSI 005 4.1 POWDER COAT WHITE (4.3.5.1) PER DART QSI 005 4.3

4) BREAK ALL SHARP EDGES 0.005 TO 0.015

- 5) TOLERANCES ARE PER DART QSI 018 UNLESS OTHERWISE NOTED
- 6) ALL DIMENSIONS ARE IN INCHES UNLESS OTHERWISE NOTED

SHOP COPY
RETURN TO
ENGINEERING
UN CONTROLLED COPY
SUBJECT TO AMENDMENT
WITHOUT NOTICE


NO 35593


Copyright @ 2004 by DART AEROSPACE LTD

THIS DOCUMENT IS PRIVATE AND CONFIDENTIAL AND IS SUPPLIED ON THE EXPRESS CONDITION THAT IT IS NOT TO BE USED FOR ANY PURPOSE OR COPIED OR COMMUNICATED TO ANY OTHER PERSON WITHOUT WRITTEN PERMISSION FROM DART AEROSPACE LTD.



DESIGN	DRAWN BY		DART AEROSPACE LTD HAWKESBURY, ONTARIO, CANADA			
CHECKED	APPROVED,	DRAWING NO.	REV. C			
一半	<del>-   </del>	D3278	SHEET 3 OF 3			
DATE		TITLE	SCALE			
07.07.24		SUPPORT ASSEMBLY	1:1			

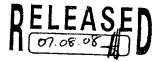

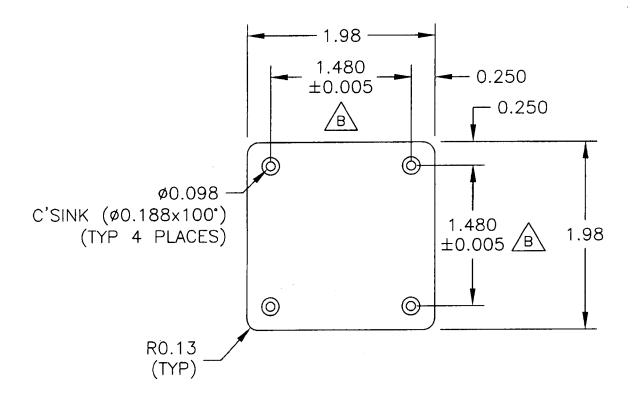

#### **D3278-3 SPACER**

1) MATERIAL: DELRIN II 150E OR ACETRON GP ACETAL (REF. DART SPEC. M-DELRIN-B0.125×2.000) OR DELRIN II 150E OR ACETRON GP ACETAL

(REF. DART SPEC. M-DELRIN-S.125)

- 2) BREAK ALL SHARP EDGES 0.005 TO 0.015
- 3) TOLERANCES ARE PER DART QSI 018 UNLESS OTHERWISE NOTED
- 4) ALL DIMENSIONS ARE IN INCHES UNLESS OTHERWISE NOTED

SHOP COPY

RETURN TO

ENGINEERING

UNCONTROLLED COPY

SUBJECT TO AMENDMENT

WITHOUT NOTICE

NO 35333

Copyright © 2004 by DART AEROSPACE LTD

THIS DOCUMENT IS PRIVATE AND CONFIDENTIAL AND IS SUPPLIED ON THE EXPRESS CONDITION THAT IT IS NOT TO BE USED FOR ANY PURPOSE OR COPIED OR COMMUNICATED TO ANY OTHER PERSON WITHOUT WRITTEN PERMISSION FROM DART AEROSPACE LTD.